


THE RED LINES SHOW WHERE SEWER WAS EITHER REPLACED, OR SLIP LINED IN 2009.

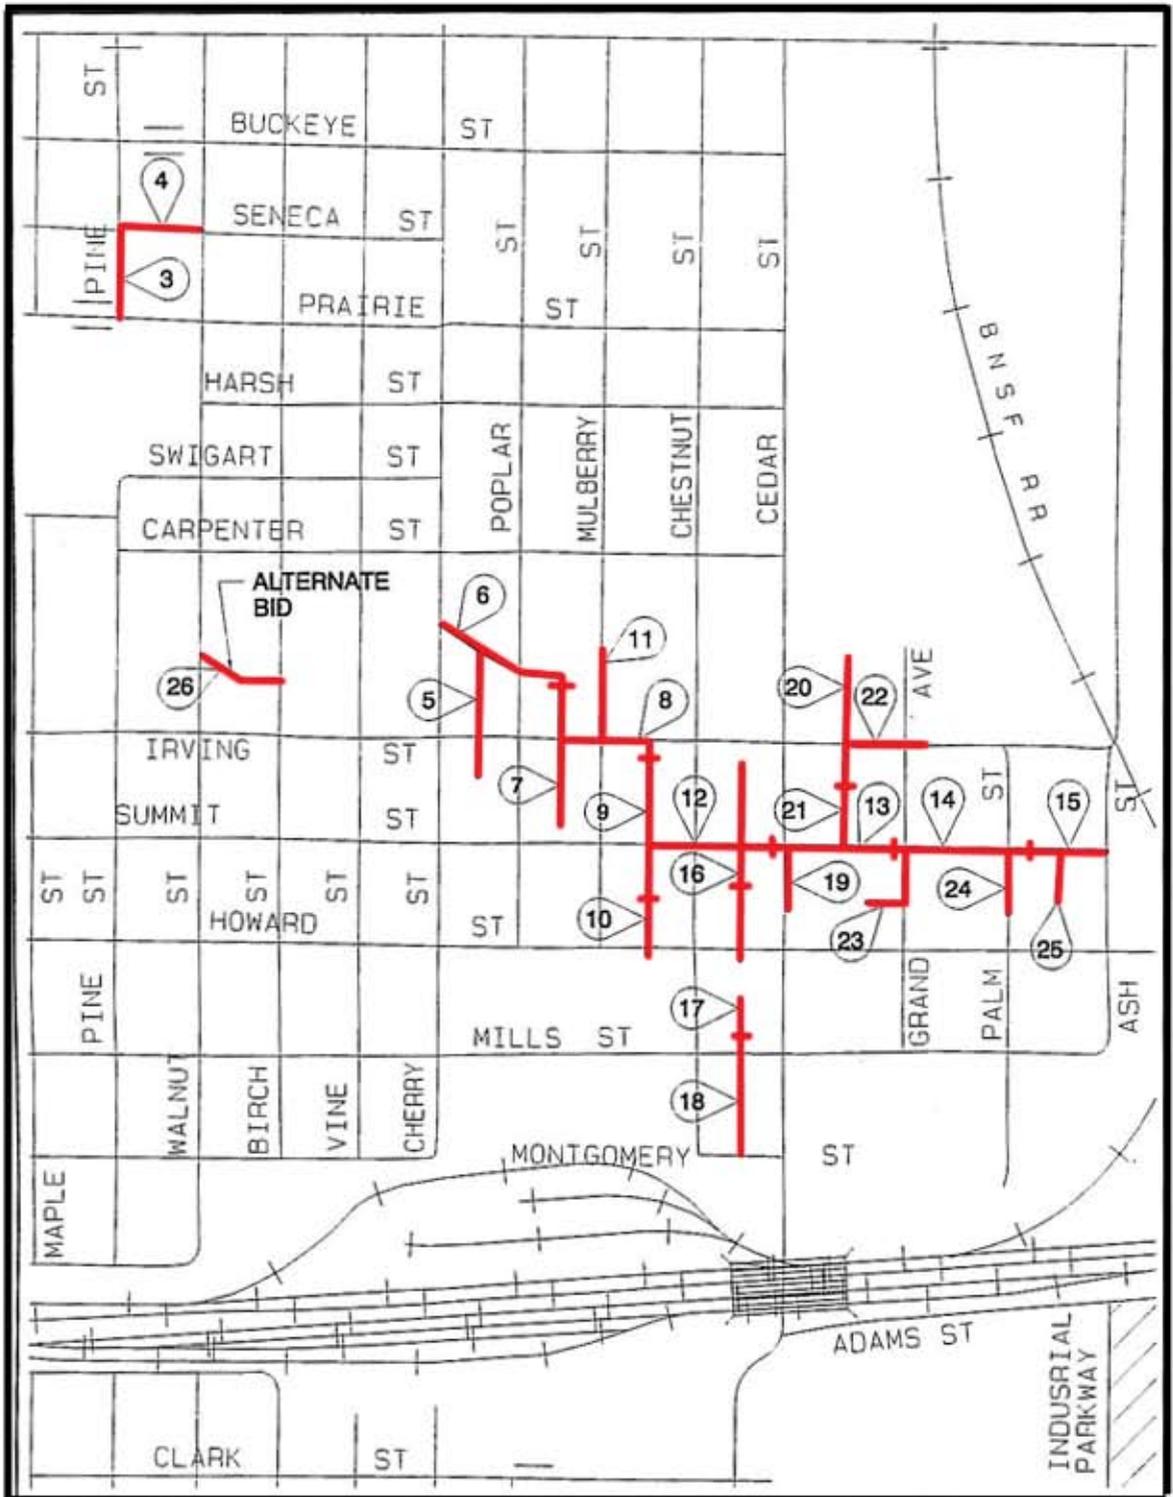

VICINITY MAP
NOT TO SCALE